

# APPLICATION FOR PERMIT

COUNTY OF LOS ANGELES  
DEPARTMENT OF COUNTY ENGINEER  
BUILDING AND SAFETY DIVISION  
JOHN A. LAMBIE, COUNTY ENGINEER  
COLEMAN W. JENKINS, SUP'T. OF BUILDING

## SEWER-SEWAGE DISPOSAL

1

### FOR APPLICANT TO FILL IN

LEGAL DESCRIPTION 509' ON N 100' W 125' E 3' OF 227125 LOT 4

BLOCK 3020 TRACT 3020

SIZE OF LOT Residence NO. OF BLDGS. NOW ON LOT

USE OF BUILDINGS Residence

CONTRACTOR Self

ADDRESS 22808 Mariposa

CITY Torrance TEL. NO. 8340179

STATE LICENSE NO. LIC CLASS

NO.	DESCRIPTION OF WORK	FEE
1	HOUSE SEWER CONNECTING TO PUBLIC SEWER	@ \$5.00
	SEPTIC TANK, SEEPAGE PIT OR PITS AND/OR DRAINFIELD	@ \$10.00
	HOUSE SEWER CONNECTING TO PRIVATE DISPOSAL SYSTEM	@ \$3.00
	CONNECT ADDITIONAL BLDG. OR WORK TO HOUSE SEWER	@ \$3.00
	OVERFLOW SEEPAGE PIT, DRAINFIELD EXTN., CESSPOOL, DRYWELL, MANHOLE	@ \$5.00
	ALTER, REPAIR OR ABANDON HOUSE SEWER OR DISPOSAL SYSTEM	@ \$3.00

BUILDING ADDRESS 22808 Mariposa

LOCALITY Torrance

NEAREST CROSS ST. 228th St

OWNER R.D. McCreedy

MAIL ADDRESS 22808 Mariposa

CITY Torrance TEL. NO. 8340179

DISTRICT NO. 12 GROUP I MAP W 117 PG Erwin

CONNECTION DATA

STATION 1492.0 DEPTH 6

MANHOLE REFERENCE 8' X 8' LOWER

TYPE OF CONNECTION P.L. LENGTH FROM M.L. TO 22

CQ. IMP. NO. 2303M P.C. NO. JOB NO.

TRUNK PERMIT NO. ROAD PERMIT NO.

AFFIDAVIT WAIVER EASEMENT RECORD. INSTR. NO. DATE

HWY. OR ST. WIDENING

STATE ENCROACHMENT PERMIT NO.

INDUSTRIAL WASTE APPROVAL

OWNER'S AUTHORIZATION

PERMIT \$ 2.00

TOTAL FEE 7.00

I HAVE AT THIS DATE A CONTRACT WITH THE HEREIN-NAMED CONTRACTOR TO CONNECT THE ABOVE DESCRIBED EXISTING DWELLING TO THE PUBLIC SEWER.

SIGNED THIS \_\_\_\_\_ DAY OF \_\_\_\_\_ 19\_\_\_\_

OWNER OR OWNERS AGENT \_\_\_\_\_

ADDRESS \_\_\_\_\_

I HEREBY ACKNOWLEDGE THAT I HAVE READ THIS APPLICATION AND STATE THAT THE ABOVE IS CORRECT AND AGREE TO COMPLY WITH ALL COUNTY ORDINANCES AND STATE LAWS REGULATING PLUMBING AND SEWERS.

I HEREBY CERTIFY THAT I AM PROPERLY REGISTERED AND/OR LICENSED AS REQUIRED BY LOS ANGELES COUNTY AND STATE OF CALIFORNIA OR THAT I AM THE LEGAL OWNER OF, AND INTEND TO RESIDE IN, THE ABOVE DESCRIBED RESIDENTIAL PROPERTY.

SIGNATURE OF PERMITTEE R.D. McCreedy

CHARGES

CONNECTION CHARGE FEE

REIMBURSEMENT FEE

APPROVALS

	DATE	INSPECTOR'S SIGNATURE
NEW HOUSE SEWER	<u>5-25-68</u>	<u>Erwin</u>
CONNECT ADDITIONAL BUILDING OR WORK		
SEPTIC TANK, SEEP, PIT(S) AND/OR DRAINFIELD		
CESSPOOL <input type="checkbox"/> DRYWELL <input type="checkbox"/>		
ALTER, REPAIR, SEWER OR SEWAGE DISPOSAL SYSTEM		
DISCONNECT PLUG AND ABANDON HOUSE SEWER		
BACKFILL SEPTIC TANKS <input checked="" type="checkbox"/> SEEP, PIT(S) <input checked="" type="checkbox"/> CESSPOOLS <input type="checkbox"/>	<u>5-25-68</u>	<u>Erwin</u>

### VALIDATION

CK. M.O. CASH

JACK R. ALLEN

SUPERVISING MECHANICAL ENGINEER

1072768 MAY 23 1968 7.00


E. Erwin

INSPECTOR COPY

FOR DEPARTMENT USE

REQUIRED INFORMATION

1. INDICATE ALL BUILDINGS ON PROPERTY.
2. INDICATE AND DIMENSION SEWAGE DISPOSAL SYSTEM WITH TIE DISTANCES TO BUILDINGS AND PROPERTY LINES.
3. INDICATE SIZE OF SEPTIC TANK—DEPTH OF SEEPAGE PIT(S)—SIZE OF CESSPOOL(S).
4. INDICATE NORTH DIRECTION ON PLOT.
5. INDICATE BOTH STREETS IF CORNER.

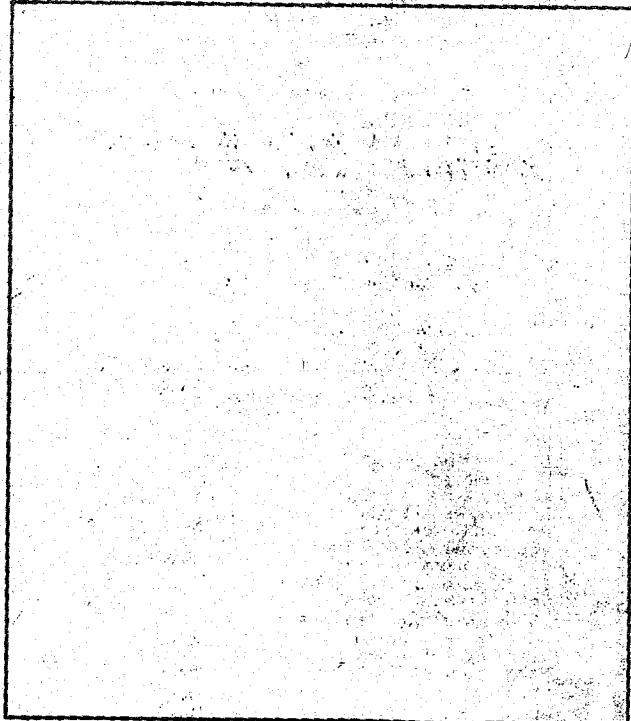

ST. ALLEY R/W

FIELD NOTES 5-27-68-4' line pt.  
except of house connection -  
septic tank & seepage pits (2)  
not ~~at~~ filled in - Wm  
5-28-68 OK to cover all  
V.C.P. - Wm